

KEYED NOTES:

GENERAL NOTES:

ISSUE


23/12

02/16/12

ISSUE FOR BID

ISSUED FOR PERMIT

02/23/12 CITY COMMENTS

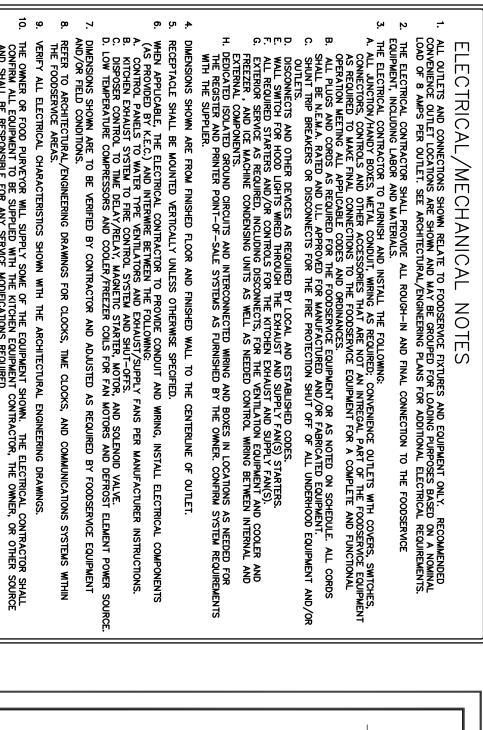

OPEN NUMBER
REFRIGERATOR

REFRIGERATOR

7. 0 AMP

넮

NOTES

025 041

REFRIGERATOR
ICE MACHINE
REGISTERS/POS TERM
CONVENIENCE OUTLET

TERMINALS

120/1 120/1 120/1 120/1

12. 1 AMP 12. 7 AMP 20 AMP

DR SR/JB

12"
72"
VERIFY
48"

MULTIPL

E LOCATIONS,

DEDICATED IG,

SEE NOTE

CONVENIENCE DUTLE

024 022

GRINDER

120/1 120/1 120/1

CONTROL
SEE BELOW
6. 0 AMP
8. 4 AMP

DW HOOD
SERVICE
JUICER

- EXH FAN [FU5] - FAN SWITCH

11. 4 AMP 4. 1 AMP

027 027 027 027 027 027 028

DPEN NUMBER

HOOD - EXHAUST FAN- FU1 2

HOOD - SUPPLY FAN -FU2 2

HOOD - EXHAUST FAN- FU3 2

HOOD - SUPPLY FAN -FU4 2

HOODS - LIGHTS [8] 1

208/3 208/3 208/3 208/3

3. 3 AMP 3. 3 AMP 4. 7 AMP 3. 3 AMP

된 된 된 된

召

[E25], SEE SHEETS K-4x
SUPPLIED CNTRLS, HOOD MT.,
TRE SYS NOTE, SHEETS K-4x

JFF THRU [E26]

CONVENIENCE OUTLET
FIRE SYS - REMOTE PUL
BAIN MARIE HOT WELLS

208/1

30. 8 AMP
SEE NOTES
SEE NOTES

FIRE SUPPRESSION SYSTEM CONVENIENCE OUTLET

800 WATT
CONTROL
CONTROL
SEE NOTES


THRU LE

SEE NOTES
CABLE

빙빙되띪빎빙되되되

THRU [E26]

TAIL, VERIFY LOCATION W/INSTALLER

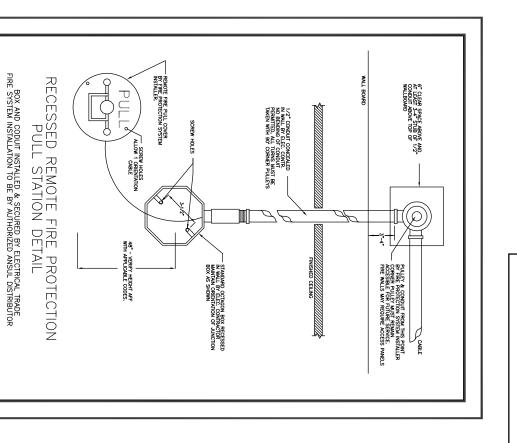

THIS IS AN EXISTING RESTAURANT TO BE REMODELLED TO OWNER SPECIFICATIONS. IT IS THE OWNER'S INTENT TO REUSE EXISTING UTILITIES WHEREVER POSSIBLE. SOME NEW UTILITIES WILL BE REQUIRED. CONNECTIONS INFORMATION IS AS NEEDED FOR EQUIPMENT TO BE SUPPLIED BY THE KITCHEN EQUIPMENT CONTRACTOR AND/OR THE OWNER. PLEASE VERIFY THE LOCATIONS AND SUITABILITY OF THE EXISTING SERVICES ON SITE AND CONFIRM WITH THE OWNER THE ACTUAL EQUIPMENT TO BE SUPPLED. CORRECT AND CODE COMPLIANT CONNECTIONS AND NEW SERVICES REQUIRED ARE THE RESPONSIBILITY OF THE APPROPRIATE MECHANICAL CONTRACTOR.

Maharaja Bhog

PROJECT NAME

SYMBOLS

SYMBOLS

DUPLEX

DUPLEX RECEPTACLE SINGLE RECEPTACLE

SWITCH

JUNCTION BOX - HARD WIRED

PROJECT ADDRESS 8338 Southwest Freeway Houston, Texas 77074

ABBREVIATIONS

VOLT - VOLTAGE

PH - PHASE

HW - HARD WIRE

JB - JUNCTION BOX

DR - DUPLEX RECEPTACLE

SR - SINGLE RECEPTACLE

- ABOVE FINISHED FLOOR
- DROP FROM ABOVE
- ELECTRICAL CONTRACTOR
- KITCHEN EQUIPMENT CONTRACTOR
- GENERAL CONTRACTOR

SHEET NAME **POWER PLAN ELECTRICAL** 

PROJECT NUMBER

DETAIL RFP-1

nep.com (832) 643-0368

CONSULTANTS 9575 Katy Frwy., #200 Houston, Texas 77024 tel: 713.722.7071 fax: 713.722.7072

RREI